

**REQUEST FOR EXPRESSION OF INTEREST FOR THE PROVISION OF WARNING TAPE/ NET FOR PIPELINE**

**REFERENCE NO.: CPP-PROC-UG-006-0206-20**

China Petroleum Pipeline Engineering Co., Ltd. (hereinafter abbreviated as CPP) as Pipeline, Feederline & Above Ground Installation Contractor for the East African Crude Oil Pipeline (EACOP) Project invites experienced and reputable Contractors to express their interest in supplying kinds of equipment/materials for EACOP Project.

The EACOP Project involves the development, construction, operation and maintenance of a crude oil export pipeline that originates in Kabaale, Uganda and delivers oil for marine export on the East African coast in the Tanga area in Tanzania.

**BRIEF DESCRIPTION OF THE SCOPE:**

♦ **Supply of warning tape/ net for PIPELINE.**

**MINIMUM REQUIREMENTS:**

Companies expressing their interest are invited to document their request with:

- 1. Proof of License/Registration Information and Profile of Supplier, including license and TIN**

certificate.

- 2. Proof of registration with the PAU National Supplier Database (NSD) for Uganda.**
- 3. Fully filled Questionnaire, Key personnel list with CV(Appendix1)and Equipment list of production and inspection(Appendix2) in requested format. (Blank regards as unqualified item.)**
- 4. Similar supplying experience within last three years(Appendix3) in requested format.**
- 5. Compliance with the Petroleum Midstream National Content Regulation # 34,2016 for Uganda.**
- 6. Copy of certificates of ISO 9001, ISO 45001, ISO 14001 or equivalent of them.**
- 7. Tax Clearance Certificate for the last three years and Audit report for the last three years.**
- 8. The supplier must be manufacturer. Manufacturer's Commitment Letter shall be provided.**
- 9. Technical requirements shall meet NO.20-warning tape/ net for PIPELINE.**

Interested companies which meet the minimum requirements and have the capacity to provide the WORK (GOODS/SERVICES) listed above should express their interest by sending together with the above listed documents an email to [supplierdata@cpptz.com](mailto:supplierdata@cpptz.com) (Max. Email Size: 20 MBs, Wettransfer link is available for huge size documents. & All documents must be submitted in the English language) on or before **24:00** hours East African Time (EAT), on **DATE(23/2/2023)**. Subject of the email should be **"EOI for CPP-PROC-UG-006-0206-20-COMPANY NAME"**. CPP reserves the right not to consider companies that submit an incorrect email subject and the incorrect format of Questionnaire, Appendix 1, 2 and 3.

The format of the required documents and relevant technical requirements(NO.20-warning tape/ net for PIPELINE) which are mentioned in Minimum Requirements should be downloaded from EACOP's website (<https://eacop.com/opportunities-by-main-construction-contractors/china-petroleum-pipeline-engineering-co-ltd/>).

Companies satisfactorily meeting the above minimum requirements will receive, subject to the signature of a Non-Disclosure Agreement (NDA), a detailed pre-qualification questionnaire for further evaluation by Company.

**CPP reserves the right not to consider companies that submit an incomplete dossier.**

**Note 1:** Only pre-qualified companies will receive an invitation to submit their bid in furtherance of the Call for Tender process.

## Questionnaire for the Pre-qualification of Procurement-AGI PPL

NOTE: Please provide documents named by serial number according to each item.

CPP reserves the right not to consider companies that submit Questionnaire filled by hand.

Item No.	Category / Question	
0	<b>NC/LC REQUIREMENTS</b>	
0.1	General Requirements	
0.1.1	Is the Applicant fully aware of the local climatic and working conditions of country and the local applicable laws to carry out the project? (Yes or No)	
0.1.2	Applicant to confirm that the full Scope of the Project can be performed. (Yes or No)	
0.2	National Content Requirements for Uganda (Applicable for Uganda)	
0.2.1	Proof of business registration and business license for Uganda.	
0.2.2	Proof of registration with the PAU National Supplier Database (NSD) for Uganda.	
0.2.3	Compliance with the Petroleum Midstream National Content Regulation # 34,2016 for Uganda.	
0.3	Local Content Requirements for Tanzania (Applicable for Tanzania)	
0.3.1	Proof of business registration and business license for Tanzania.	
0.3.2	Proof of registration/application to EWURA Local Supplier Service Provider (LSSP) database.	
0.3.3	Compliance with Petroleum (Local Content) Regulations, 2017 and Local content requirements for Tanzania.	
1	<b>GENERAL INFORMATION</b>	
1.1	Company Data	
1.1.1	Name of Applicant	
1.1.2	Introduction of Applicant (establishing time,Copies of government issued IDs for all shareholders,main business scope,etc.)	
1.1.3	Applicant address	
1.1.4	Applicant phone number	
1.1.5	Applicant email address	
1.1.6	Applicant Website	

## Questionnaire for the Pre-qualification of Procurement-AGI PPL

NOTE: Please provide documents named by serial number according to each item.

CPP reserves the right not to consider companies that submit Questionnaire filled by hand.

Item No.	Category / Question	
1.1.7	* Manufacturer's Commitment Letter The supplier must be manufacturer.	
1.2	Authorized contact person and contact details	
1.2.1	Name of authorized contact person	
1.2.2	Contact person's business address - phone number	
1.2.3	Contact person's business address - mobile phone number	
1.2.4	Contact person's business address - email address	
1.3	Organization Chart	
1.3.1	Applicant is requested to attach its organization chart.	
1.4	Language	
1.4.1	English shall be used as the Project language for all documents and correspondence - applicant to confirm	
<b>2</b>	<b>FINANCIAL ASPECTS</b>	
2.1	Bank information	
2.1.1	Name of Applicant's principal bank	
2.1.2	Address of Applicant's principal bank - street and number	
2.1.3	Address of Applicant's principal bank - post code and city	
2.1.4	Address of Applicant's principal bank - country (and state)	
2.2	* Registration with the Tax Revenue Authority	
2.2.1	Registration with the Uganda Tax Revenue Authority, including TIN Certificate.(Applicable for Uganda)	
2.2.2	Registration with the Tanzania Tax Revenue Authority, including TIN Certificate.(Applicable for Tanzania)	
2.3	* Proof of Tax Clearance Certificate	
2.3.1	Proof of Uganda Tax Clearance Certificate for the latest 3 years available.(Applicable for Uganda)	

## Questionnaire for the Pre-qualification of Procurement-AGI PPL

NOTE: Please provide documents named by serial number according to each item.

CPP reserves the right not to consider companies that submit Questionnaire filled by hand.

Item No.	Category / Question	
2.3.2	Proof of Tanzania Tax Clearance Certificate for the latest 3 years available. (Applicable for Tanzania)	
2.4	Audited financial statements	
2.4.1	Applicant 's financial performance documents, Audited Balance sheets and Profit and Loss statements, Auditors Report and Notes to Accounts etc. for last 3 (three) years. Latest financial statement should not be older than 18 months on the date of submission of response to this Expression of Interest.	
2.5	Line of credit	
2.5.1	The line of credit shall not be less than USD 5 million, and the bid bond and performance bond shall only be issued by internationally renowned banks. (Yes or No)	
<b>3</b>	<b>LITIGATION HISTORY, RISK ASSESSMENT AND ELIGIBILITY</b>	
3.1	Litigation or arbitration history	
3.1.1	Provide information on any history of litigation or arbitration resulting from orders executed in the last (5) years or currently under execution, especially with CPP. (Yes or No)	
3.2	Eligibility	
3.2.1	Does Applicant appear on World Bank's common List of Ineligible Entities available under the following link <a href="http://www.worldbank.org/debarr">http://www.worldbank.org/debarr</a> or is Applicant subject to any sanction from World Bank and from UN? This must be similarly affirmed if the Applicant is an Affiliate or otherwise directly or indirectly controlled by such an ineligible entity. (Yes or No)	
<b>4</b>	<b>QA/QC, HSE, CERTIFICATES, KEY PERSONNEL</b>	
4.1	Please provide Applicant's ISO 9001:2015 Certificate.	
4.2	Please provide Applicant's ISO 45001:2018 Certificate (or equivalent).	
4.3	Please provide Applicant's ISO 14001:2015 Certificate (or equivalent).	
4.4	Please provide QA/QC manuals.	

## Questionnaire for the Pre-qualification of Procurement-AGI PPL

NOTE: Please provide documents named by serial number according to each item.

CPP reserves the right not to consider companies that submit Questionnaire filled by hand.

Item No.	Category / Question	
4.5	Any other technical Certificates (API, etc.).	
4.6	Please provide key personnel list, Format refer to Appendix 1.	
4.6.1	Please provide QA Manager's CV	
4.6.2	Please provide QC Inspector's CV	
4.6.3	Please provide Production Manager's CV	
<b>5</b>	<b>FABRICATION AND DESIGN</b>	
5.1	Range of products for oil and gas industry the applicant produces. (Yes or No)	
5.2	Please give details of your manufacturing and design/engineering facilities (size, area, number, etc.).	
5.3	Do you have in house design facilities? (Yes or No)	
5.4	Please provide details of the assembly yard/facilities you would use for the various parts of the project.	
5.5	Please provide the equipment list of production and inspection, Format refer to Appendix 2.	
5.6	*Technical requirements shall meet our relevant technical requirements documents attached. (Yes or No)	
<b>6</b>	<b>PROJECT SPECIFIC OUTPUT, CAPACITY, ABILITY</b>	
6.1	Please specify estimated average capacity per month for manufacturing and delivery of the product.	
6.2	What is the available capacity (i.e. not yet booked) of the Applicant for the product in Year 2023?	
6.3	According to your present workload what is the approximate time period (in weeks) for the first dispatch after purchase order award (on EXW basis)?	
<b>7</b>	<b>EXPERIENCE RECORD AND REFERENCES</b>	
7.1	Please provide similar experience within last three years, Format refer to Appendix 3.	
7.2	Please provide scanned CONTRACT for completed project or LETTER of AWARD for ongoing projects, completion certificate (if any), appreciation letters (if any) etc.	
7.3	Please confirm whether there have been any product quality incidents in the past 5 years. (Yes or No)	
<b>8</b>	<b>RAW MATERIALS</b>	

## Questionnaire for the Pre-qualification of Procurement-AGI PPL

NOTE: Please provide documents named by serial number according to each item.

CPP reserves the right not to consider companies that submit Questionnaire filled by hand.

Item No.	Category / Question	
8.1	Please list the Sub-suppliers of raw materials (Company Name, Country).	
<b>9</b>	<b>SPARE PARTS AND MAINTENANCE</b>	
9.1	Supply list of recommend spare part for the product. (If applicable)	
<b>10</b>	<b>DIVERSE DATA</b>	
10.1	Please confirm that you will provide on-site Services such as provision of re-assembly, supervision of site acceptance, assistance during quality warranty period. (If applicable, Yes or No)	

**APPENDIX 1 List of the Key Personnel**

No.	Title	Name	Years of Experience	Qualification Certificates		Location	Notes
				Name of the Certificate	Certificate No.		

Notes: pls attach the CV & scanned copies of certificates etc.


**APPENDIX 2 List of Main Equipment**

No.	Name of Main Equipment	Brand & Model	Qty.	Status of Equipment	Self-owned (Y/N)	Location of Equipment	Date of Production	Notes

Notes: This format includes equipment of production and inspection, pls attach photos and self-owned certificate etc.





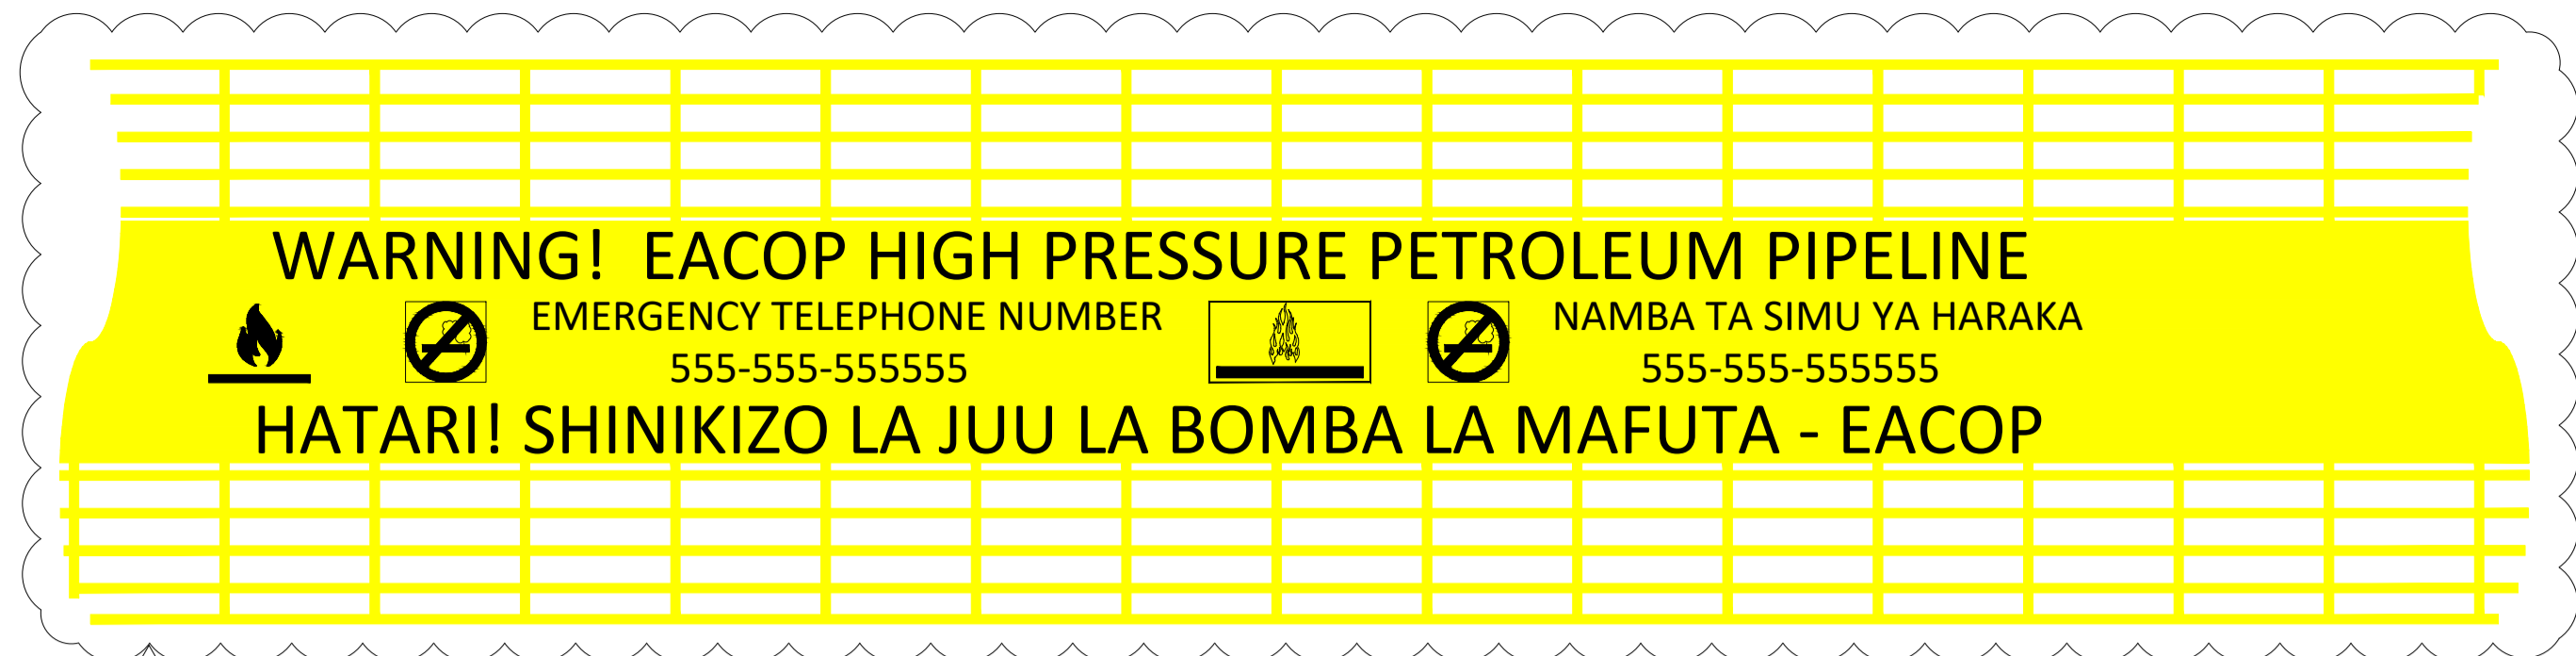

**PIPELINE WARNING TAPE**  
(FOR DIMENSIONS SEE DETAIL 1)



**FIBRE OPTIC CABLE WARNING TAPE**  
(FOR DIMENSIONS SEE DETAIL 2)



**HIGH VOLTAGE ELECTRICAL CABLE WARNING TAPE**  
(FOR DIMENSIONS SEE DETAIL 2)



**DETAIL 1**  
**PIPELINE WARNING TAPE DIMENSIONS**



**DETAIL 2**  
**CABLE WARNING TAPE DIMENSIONS**

**GENERAL NOTES:**

- ALL DIMENSIONS ARE IN MILLIMETRES UNLESS NOTED OTHERWISE.
- THIS DRAWING SHALL BE READ IN CONJUNCTION WITH THE PIPELINE CONSTRUCTION SPECIFICATION, DOC. NO. UT-MID-70-WPR2-190010.
- TAPE COLOURS SHALL BE AS FOLLOWS:  
PIPELINE AND HV CABLE: RAL 1026 (LUMINOUS YELLOW)  
FOC: RAL 6038 (LUMINOUS GREEN)
- TAPES SHALL BE VIRGIN GRADE LDPE. THEY SHALL BE ROT RESISTANT IN ALL SOILS ENCOUNTERED ALONG THE ROUTE AND HAVE A SERVICE LIFE THAT EXCEEDS THE DESIGN LIFE OF THE PIPELINE. TAPES SHALL ALLOW 25% STRETCHING WITHOUT BREAKING. MINIMUM THICKNESS SHALL BE 100 MICRONS.
- TAPES AND PIGMENTS SHALL BE FREE OF ANY SUBSTANCES THAT COULD RELEASE TOXINS INTO THE SOIL. ALL PIGMENTS SHALL BE LEAD FREE.

**HOLDS:**

- EMERGENCY CONTACT NUMBER.

**REFERENCE:**

DOCUMENT NUMBER	DOCUMENT TITLE
UT-MID-70-WPR2-190010	SPECIFICATION FOR PIPELINE CONSTRUCTION

Rev.	Date	Step	Revision Description	Iss.	Check.	Appr.
01	16/Nov/2022	AFC	APPROVED FOR CONSTRUCTION	NMN	JHY	MJD
00	10/Dec/2021	AFC	APPROVED FOR CONSTRUCTION	NMN	JHY	MJD




**EACOP Project**


This document is the property of the COMPANY and it shall not be disclosed to third parties or reproduced without the express written permission of the COMPANY. This document has been generated by an Electronic Document Management System. When printed it shall be considered as "for information only". The controlled copy is the EDMS version and it is document holder's responsibility to make sure that latest version is in use.



Affiliate:	Site:	UTP	Project Phase:	DE
------------	-------	-----	----------------	----

**TYPICAL PIPELINE DETAILS**  
**PIPELINE AND CABLE WARNING TAPES (TANZANIA)**


Discipline:	PLR	Doc. Type:	TYP	Sector:	72	System:	23
Company Doc. N°:	TZ-UTP-72-WPR2-191501			Class:	2	Scale:	NTS.
Contractor Doc. N°:		Format:	A1	Folio:	1 of 1		

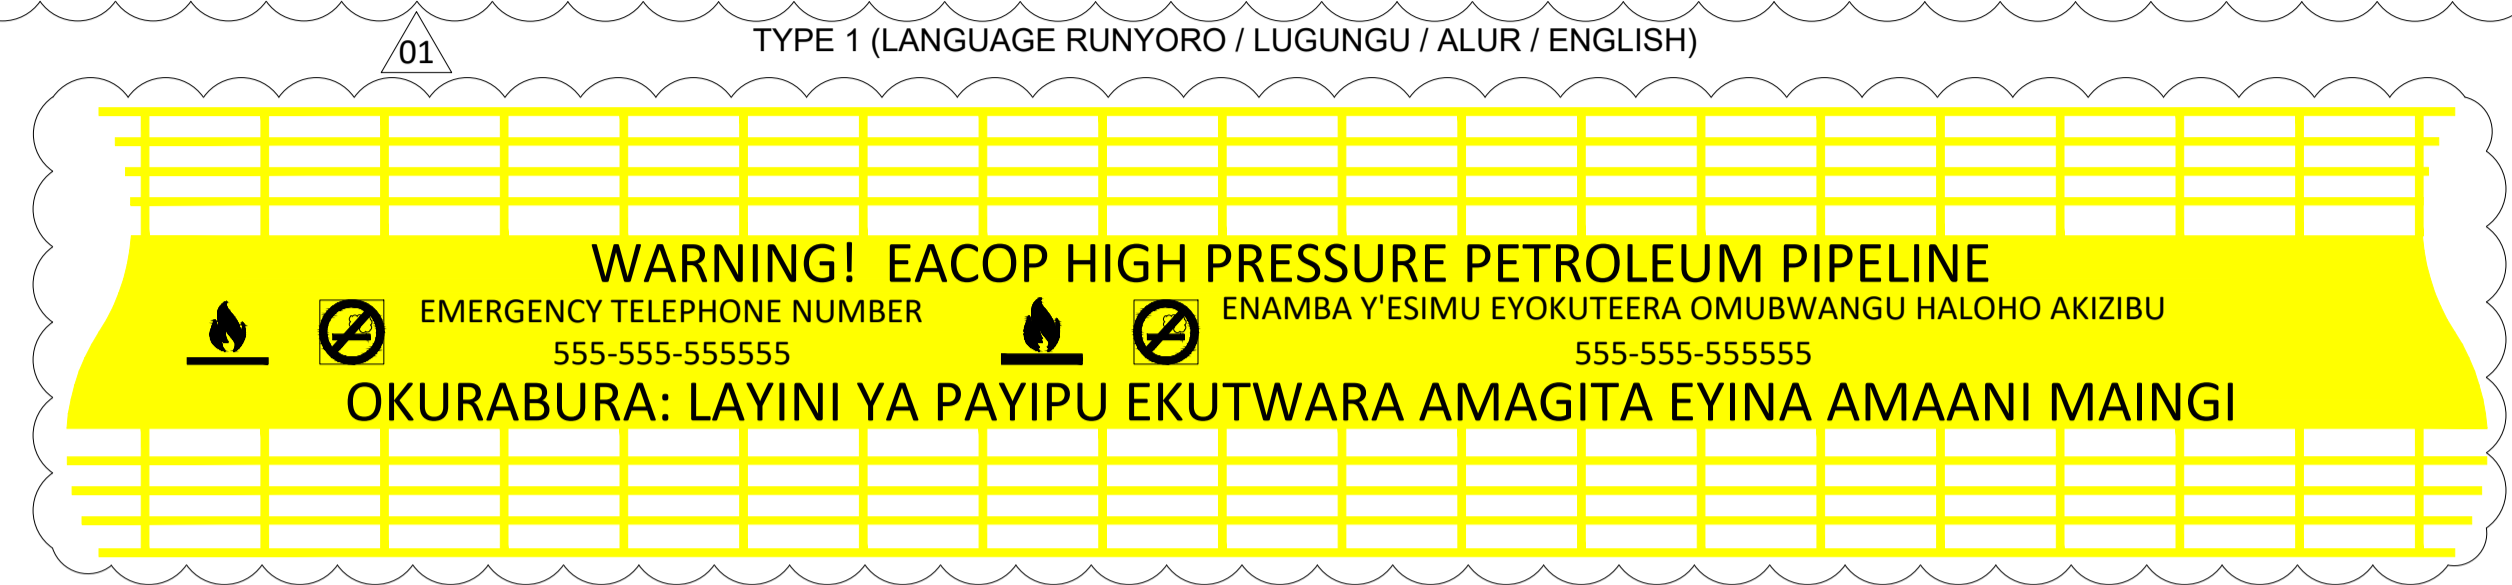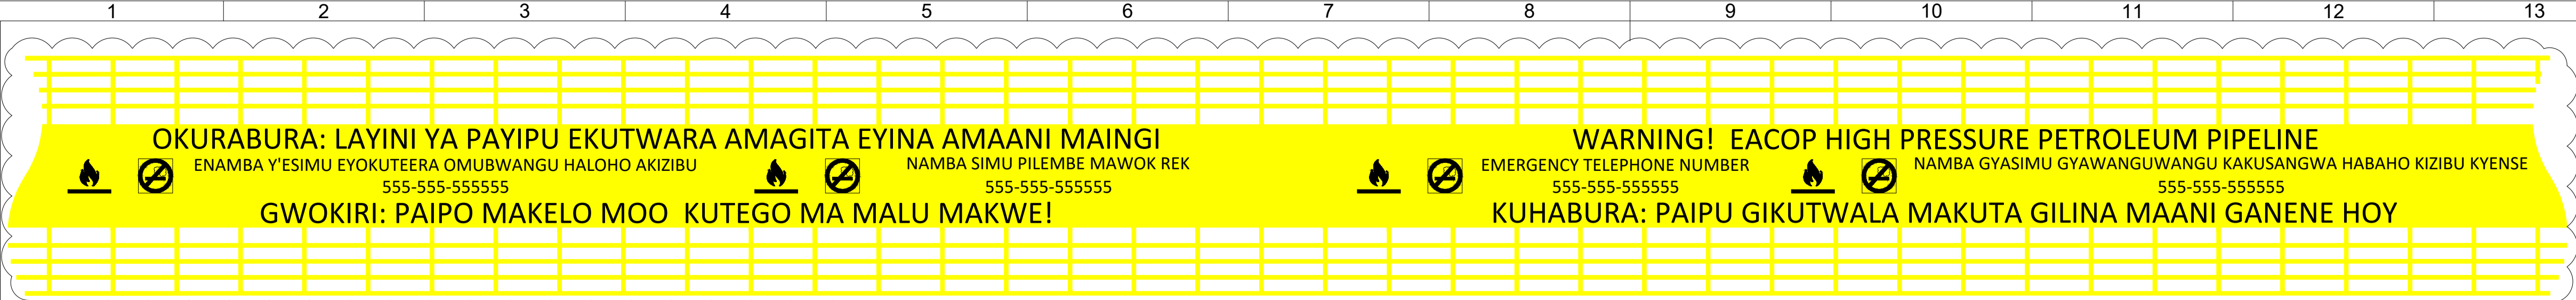



TYPE 2 (LANGUAGE RUNYORO / ENGLISH)  
**FEEDER LINE WARNING TAPE**  
(FOR DIMENSIONS SEE DETAIL 1)

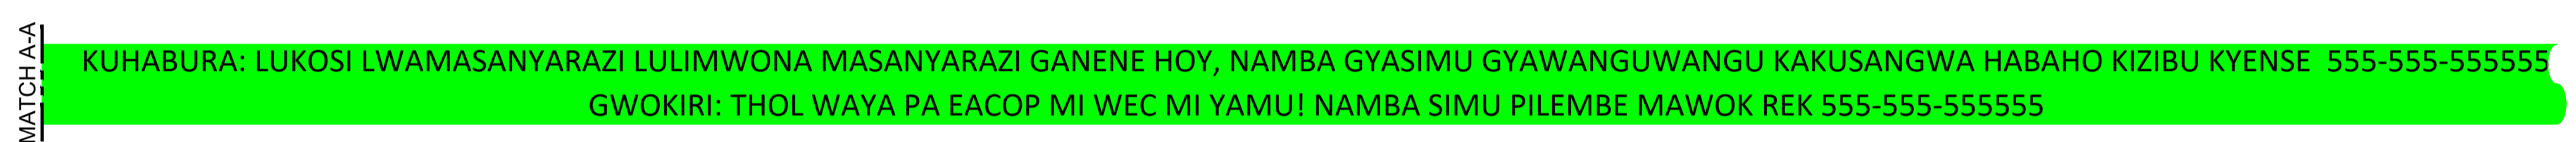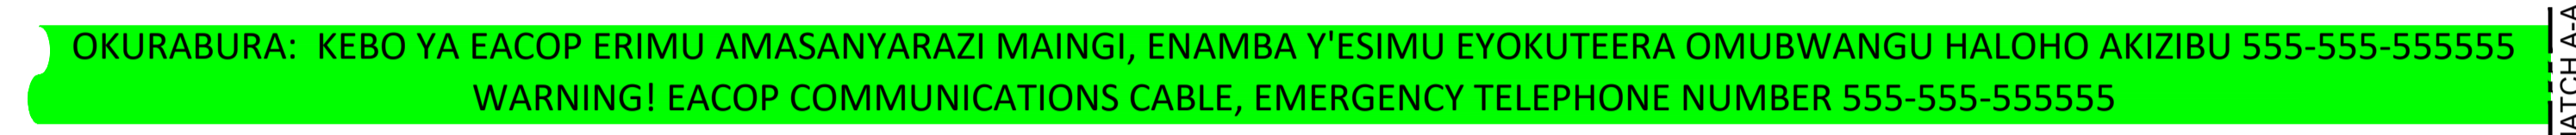


TYPE 1 (LANGUAGE RUNYORO / LUGUNGU / ALUR / ENGLISH)

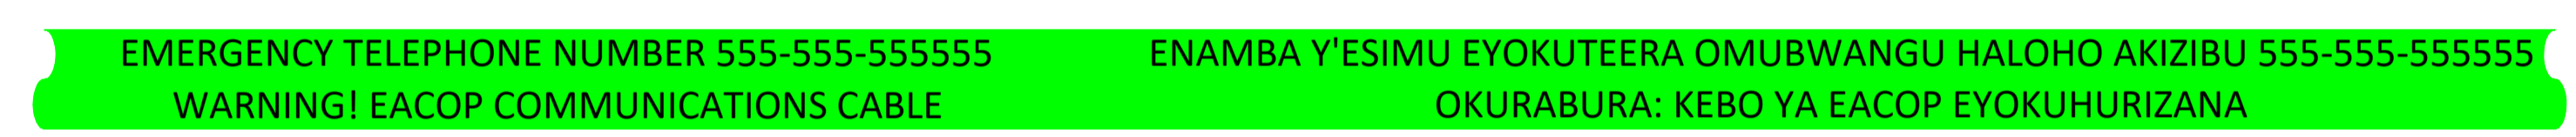


TYPE 2 (LANGUAGE RUNYORO / ENGLISH)  
**FIBRE OPTIC CABLE WARNING TAPE**  
(FOR DIMENSIONS SEE DETAIL 2)

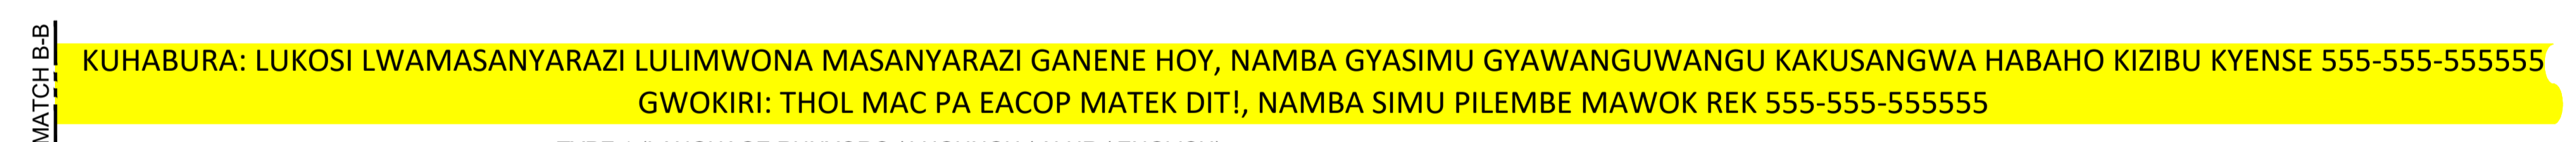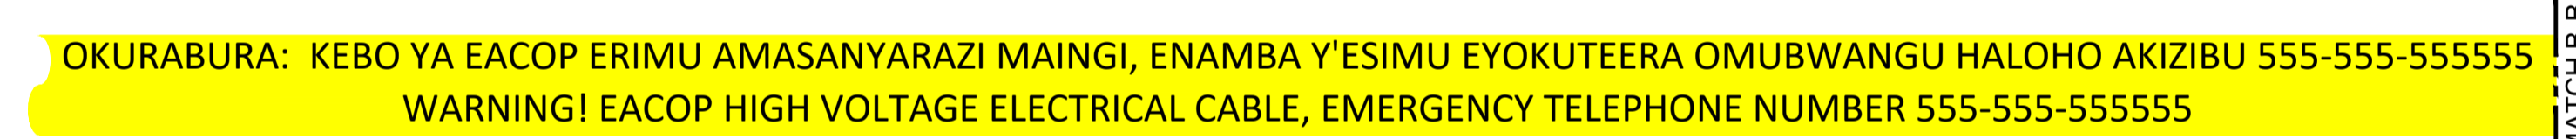


TYPE 1 (LANGUAGE RUNYORO / LUGUNGU / ALUR / ENGLISH)

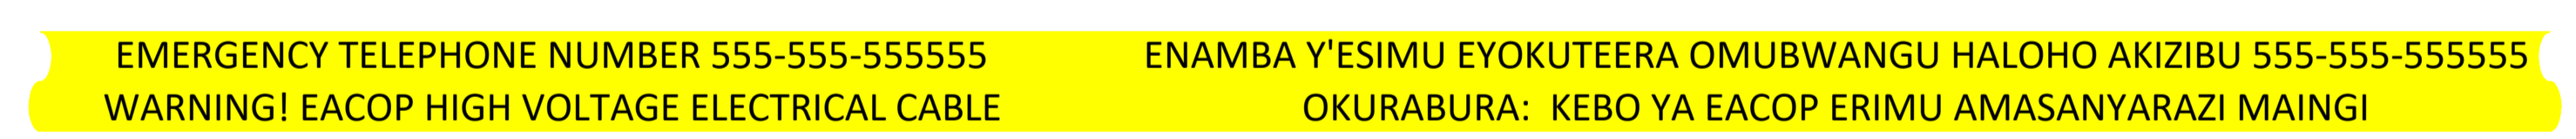

TYPE 2 (LANGUAGE RUNYORO / ENGLISH)  
**HIGH VOLTAGE ELECTRICAL CABLE WARNING TAPE**  
(FOR DIMENSIONS SEE DETAIL 2)

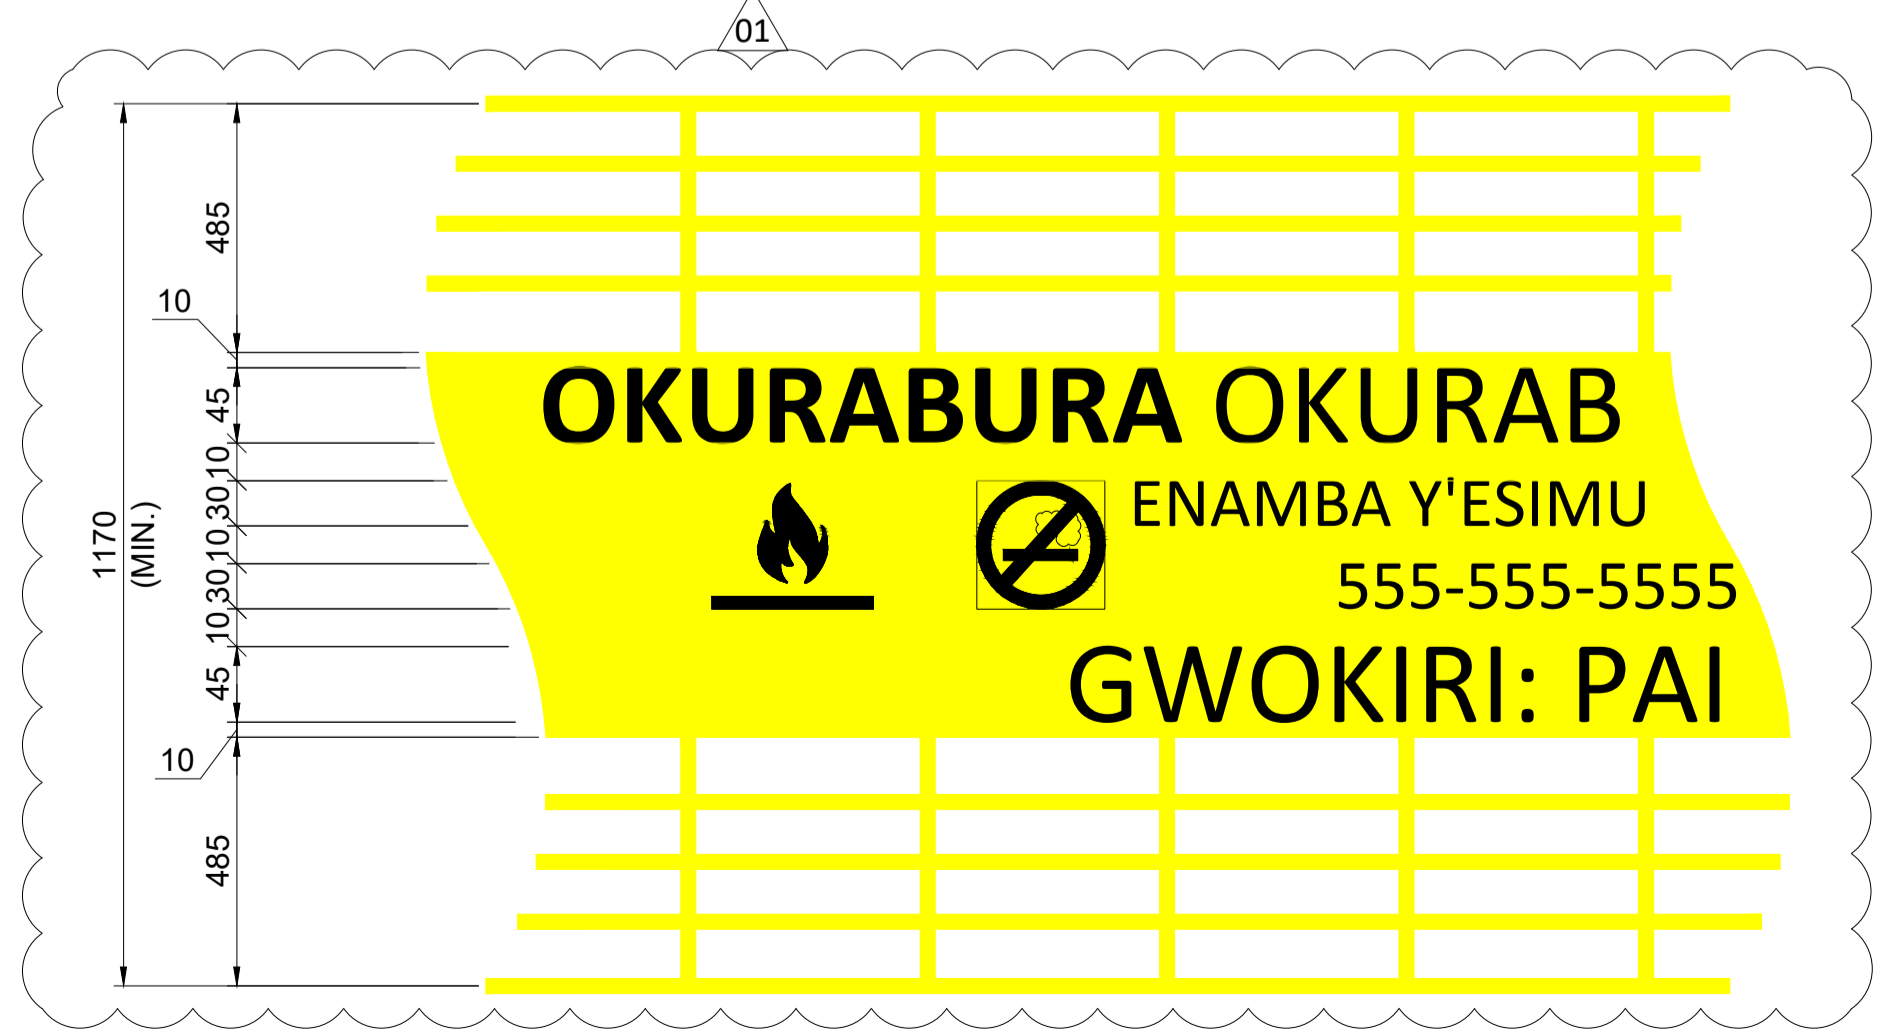

DETAIL 1  
**FEEDER LINE WARNING TAPE DIMENSIONS**

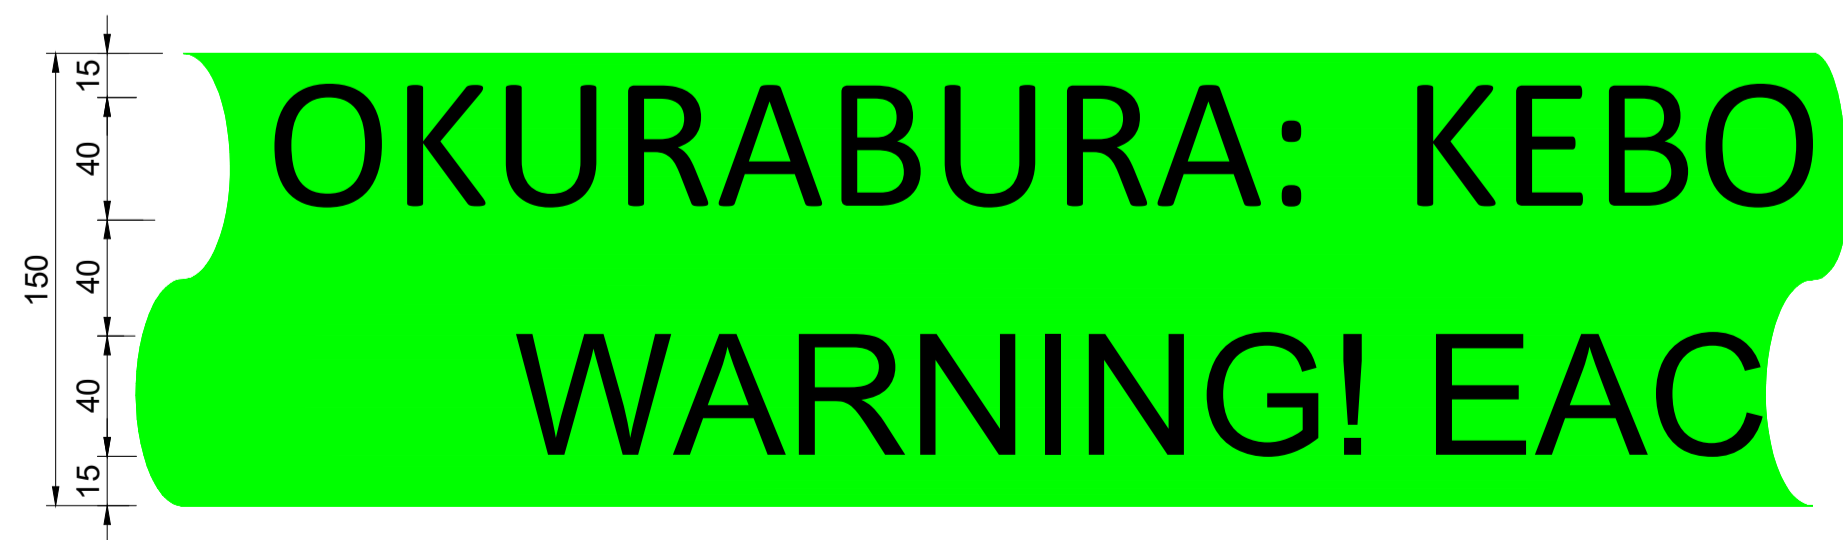

DETAIL 2  
**CABLE WARNING TAPE DIMENSIONS**

**GENERAL NOTES:**

- ALL DIMENSIONS ARE IN MILLIMETRES UNLESS NOTED OTHERWISE.
- THIS DRAWING SHALL BE READ IN CONJUNCTION WITH THE PIPELINE CONSTRUCTION SPECIFICATION, DOC. NO. UT-MID-70-WPR2-190010.
- THIS TYPICAL DETAIL APPLIES TO THE FEEDER LINE. MARKER TAPES FOR THE PIPELINE ARE SHOWN ON DRAWING NO. UG-UTP-72-WPR2-191501.
- TAPE COLOURS SHALL BE AS FOLLOWS:  
PIPELINE AND HV CABLE: RAL 1026 (LUMINOUS YELLOW)  
FOC: RAL 6038 (LUMINOUS GREEN)
- TAPES SHALL BE VIRGIN GRADE LDPE. THEY SHALL BE ROT RESISTANT IN ALL SOILS ENCOUNTERED ALONG THE ROUTE AND HAVE A SERVICE LIFE THAT EXCEEDS THE DESIGN LIFE OF THE PIPELINE. TAPES SHALL ALLOW 25% STRETCHING WITHOUT BREAKING. MINIMUM THICKNESS SHALL BE 100 MICRONS.
- TAPES AND PIGMENTS SHALL BE FREE OF ANY SUBSTANCES THAT COULD RELEASE TOXINS INTO THE SOIL. ALL PIGMENTS SHALL BE LEAD FREE.
- THE TAPE TYPES REQUIRED ALONG THE ROUTE ARE PROVIDED IN TABLE 1.

**HOLDS:**

- EMERGENCY CONTACT NUMBER.

**REFERENCE:**

DOCUMENT NUMBER	DOCUMENT TITLE
UT-MID-70-WPR2-190010	SPECIFICATION FOR PIPELINE CONSTRUCTION
TZ-UTP-72-WPR2-191501	PIPELINE AND CABLE WARNING TAPES (UGANDA)

DISTRICT	TAPE TYPE
BULIISA	1
HOIMA (FEEDER LINE)	2

**TABLE 1 - TAPE TYPE  
REQUIRED IN EACH DISTRICT**

Rev.	Date	Step	Revision Description	Iss.	Check.	Appr.
01	16/Nov/2022	AFC	APPROVED FOR CONSTRUCTION	NMN	JHY	MJD
00	10/Dec/2021	AFC	APPROVED FOR CONSTRUCTION	NMN	JHY	MJD


**EACOP Project**


This document is the property of the COMPANY and it shall not be disclosed to third parties or reproduced without the express written permission of the COMPANY. This document has been generated by an Electronic Document Management System. When printed it shall be considered as "for information only". The controlled copy is the EDMS version and it is document holder's responsibility to make sure that latest version is in use.

Affiliate: Site: TIF Project Phase: DE

**TYPICAL PIPELINE DETAILS**  
**FEEDER LINE AND CABLE WARNING TAPES**

Discipline:	PLR	Doc. Type:	TYP	Sector:	71	System:	23
Company Doc. N°:	UG-TIF-71-WPR2-191502			Class:	2	Scale:	NTS.
Contractor Doc. N°:				Format:	A1	Folio:	1 of 1






TYPE 1 (LANGUAGE RUNYORO / ENGLISH)  
 (FOR DIMENSIONS SEE DETAIL 1)




TYPE 2 (LANGUAGE LUGANDA / ENGLISH)  
 (FOR DIMENSIONS SEE DETAIL 1)

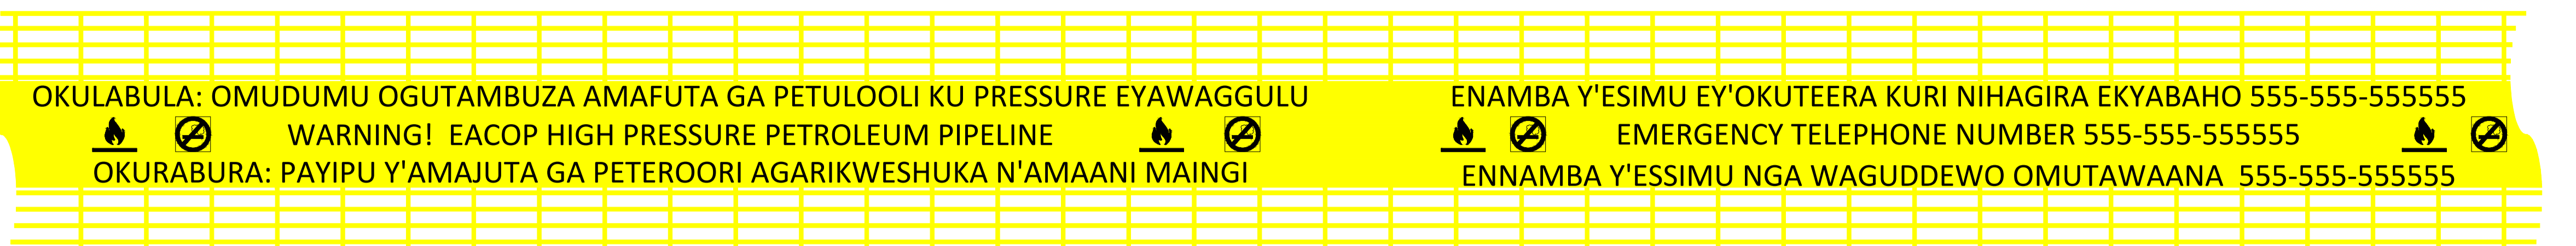


TYPE 3 (LANGUAGE RUNYANKOLE / LUGANDA / ENGLISH) (FOR DIMENSIONS SEE DETAIL 2)


**PIPELINE WARNING TAPE**

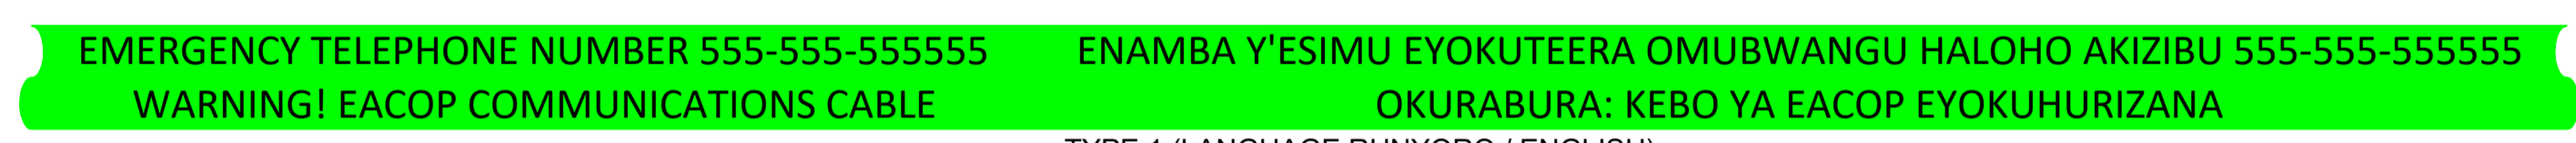

TYPE 1 (LANGUAGE RUNYORO / ENGLISH)

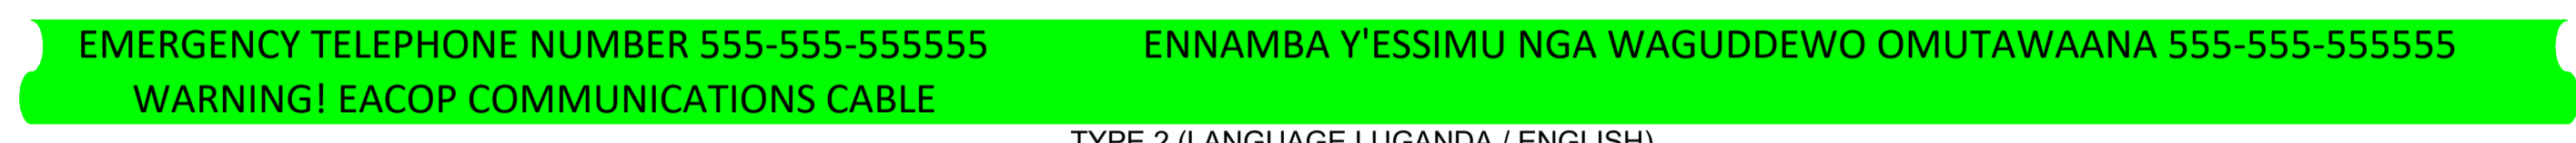


TYPE 2 (LANGUAGE LUGANDA / ENGLISH)

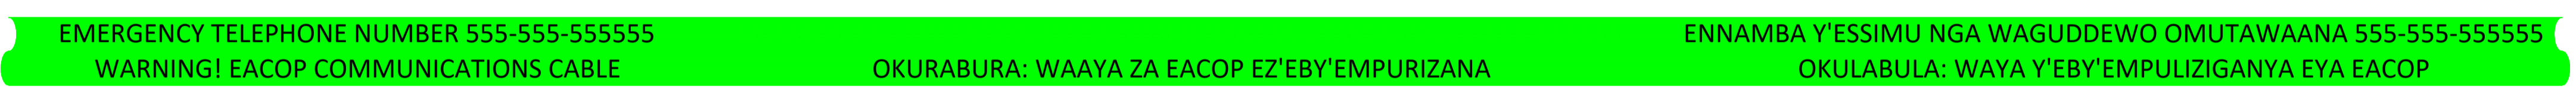


TYPE 3 (LANGUAGE RUNYANKOLE / LUGANDA / ENGLISH)

**FIBRE OPTIC CABLE WARNING TAPE**


(FOR DIMENSIONS SEE DETAIL 3)

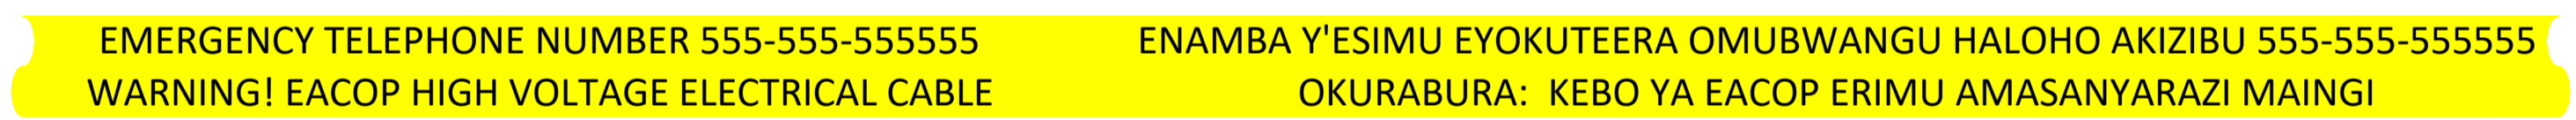

TYPE 1 (LANGUAGE RUNYORO / ENGLISH)

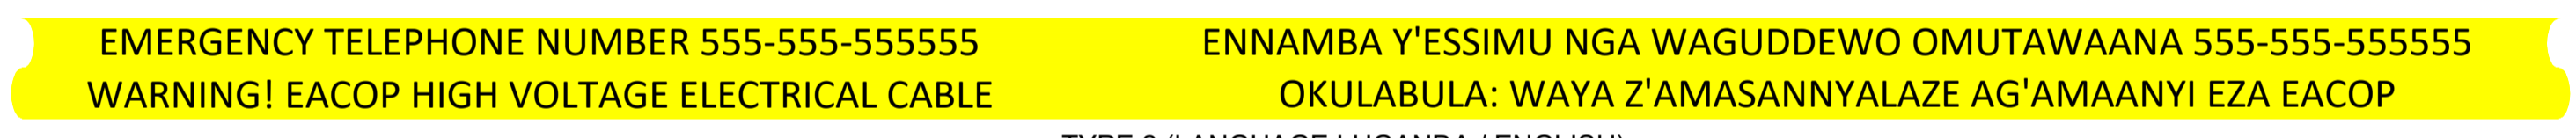


TYPE 2 (LANGUAGE LUGANDA / ENGLISH)

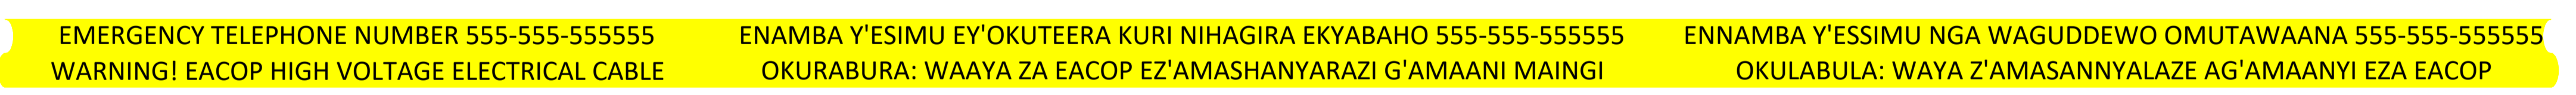


TYPE 3 (LANGUAGE RUNYANKOLE / LUGANDA / ENGLISH)

**HIGH VOLTAGE ELECTRICAL CABLE WARNING TAPE**


(FOR DIMENSIONS SEE DETAIL 3)

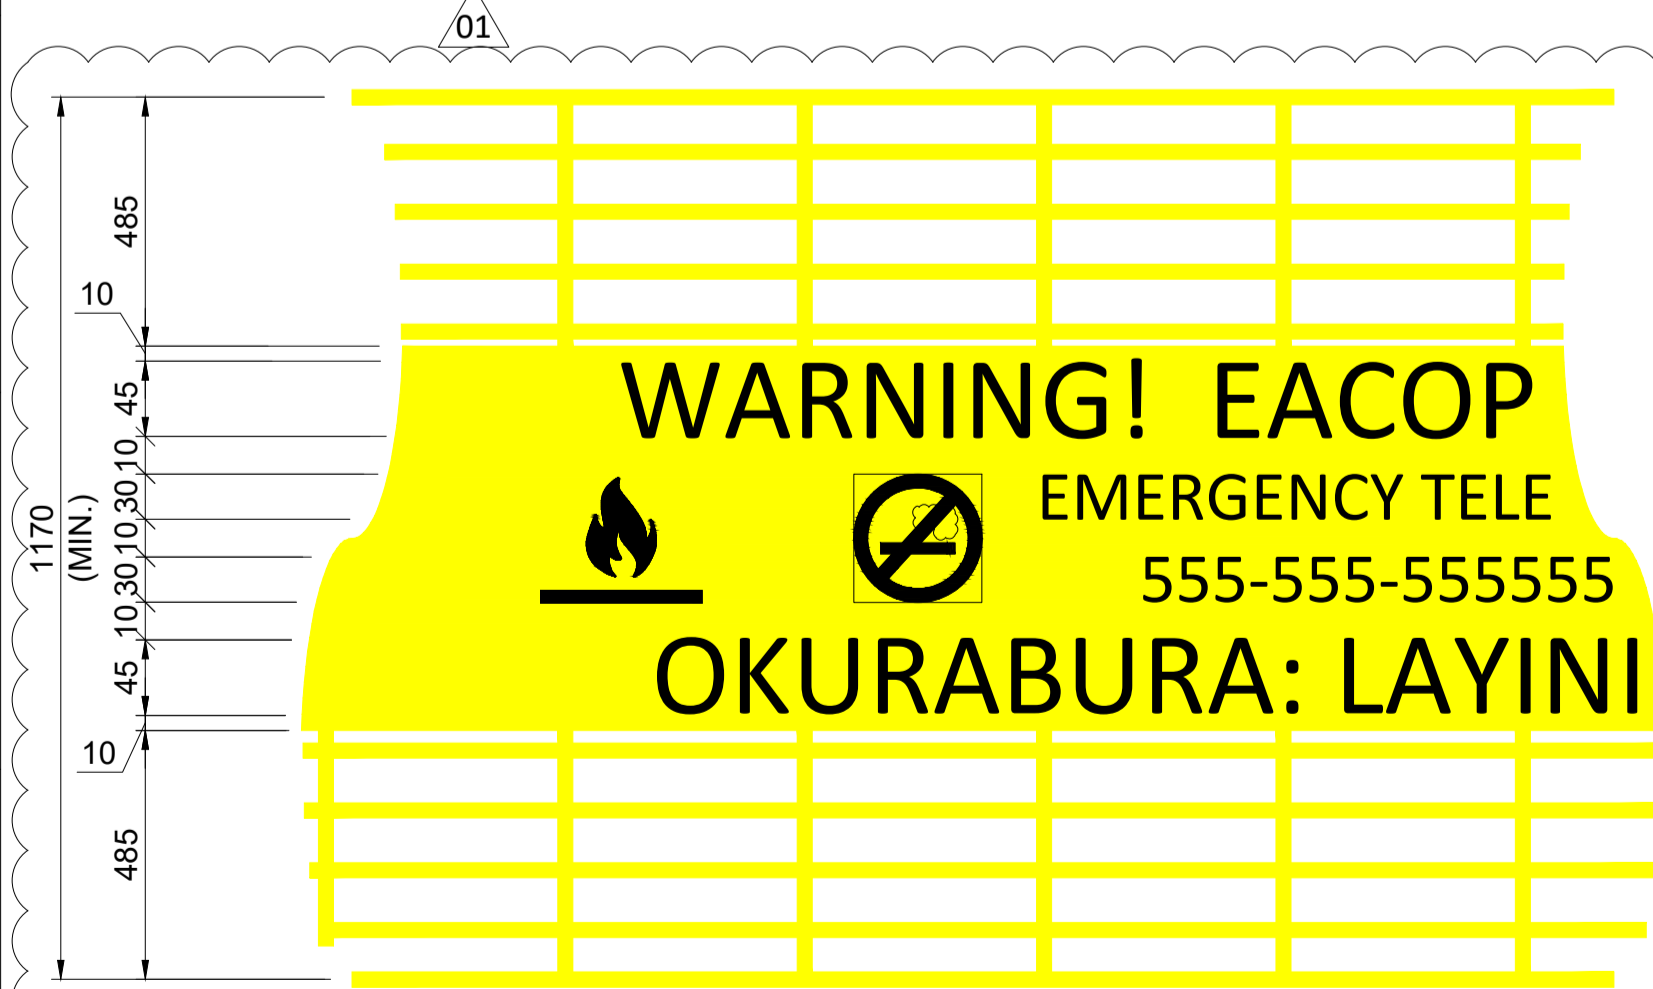

**DETAIL 1**  
**PIPELINE WARNING TAPE DIMENSIONS**  
 (TYPE 1 & 2)

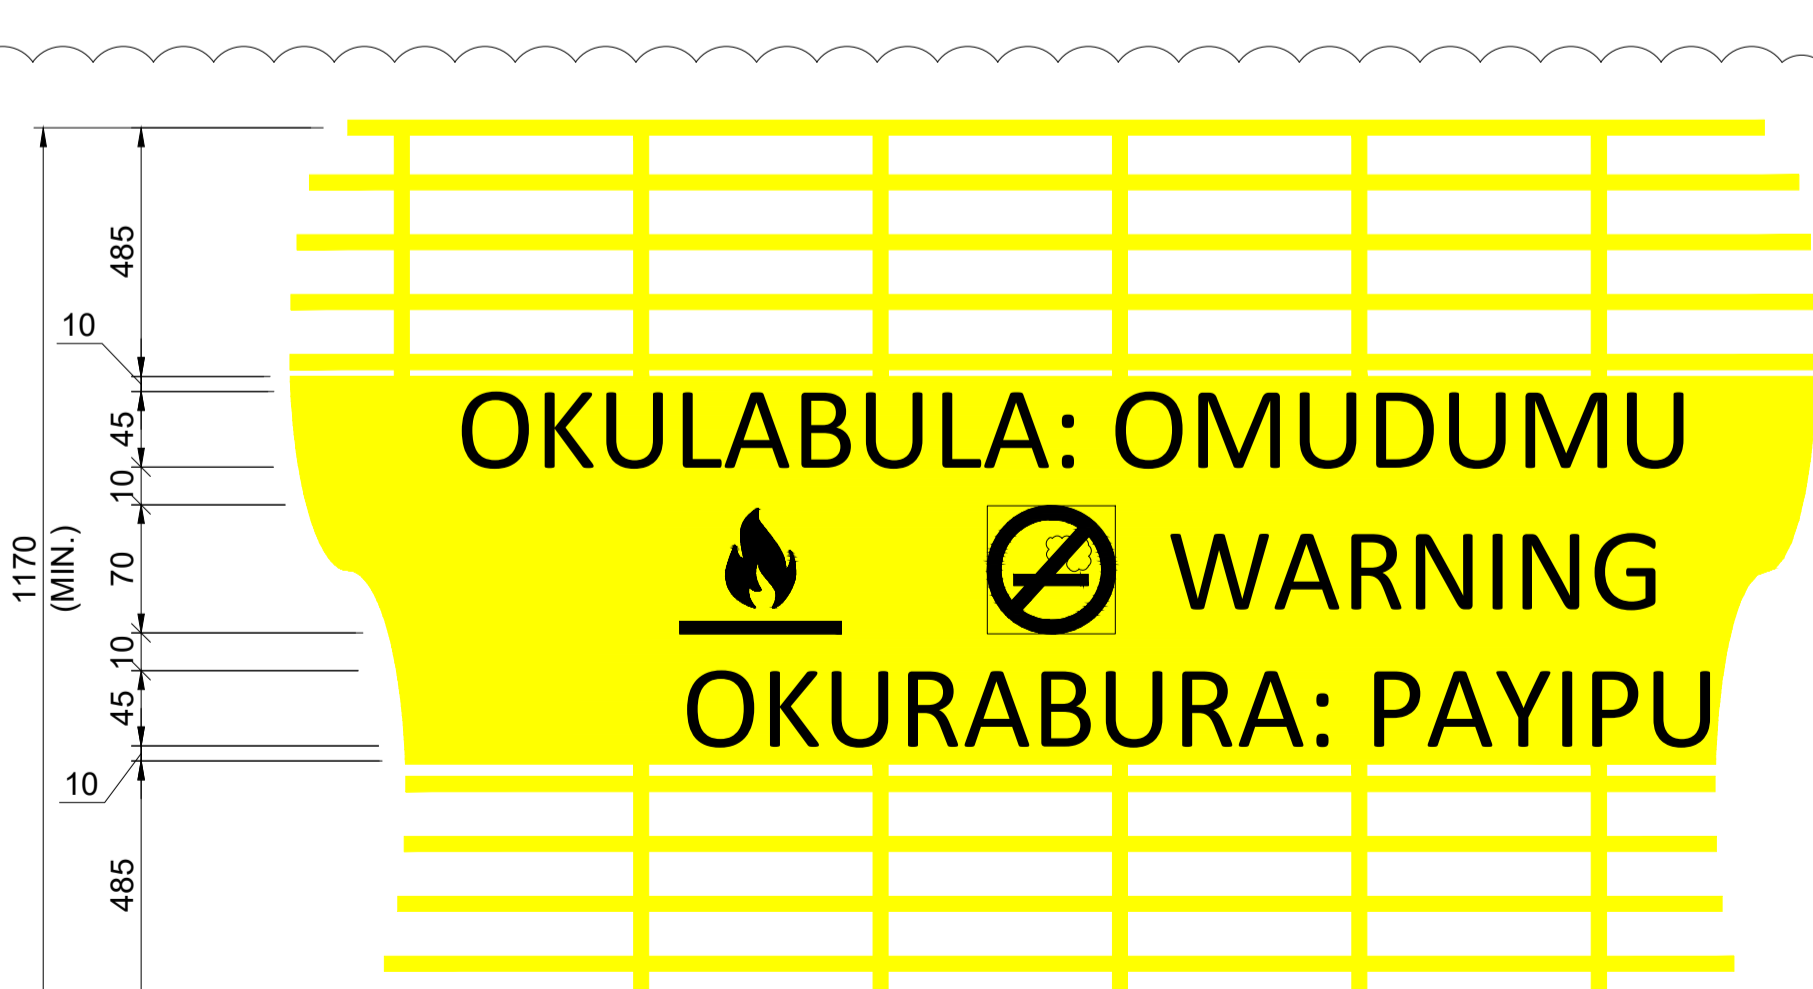

**DETAIL 2**  
**PIPELINE WARNING TAPE DIMENSIONS**  
 (TYPE 3)

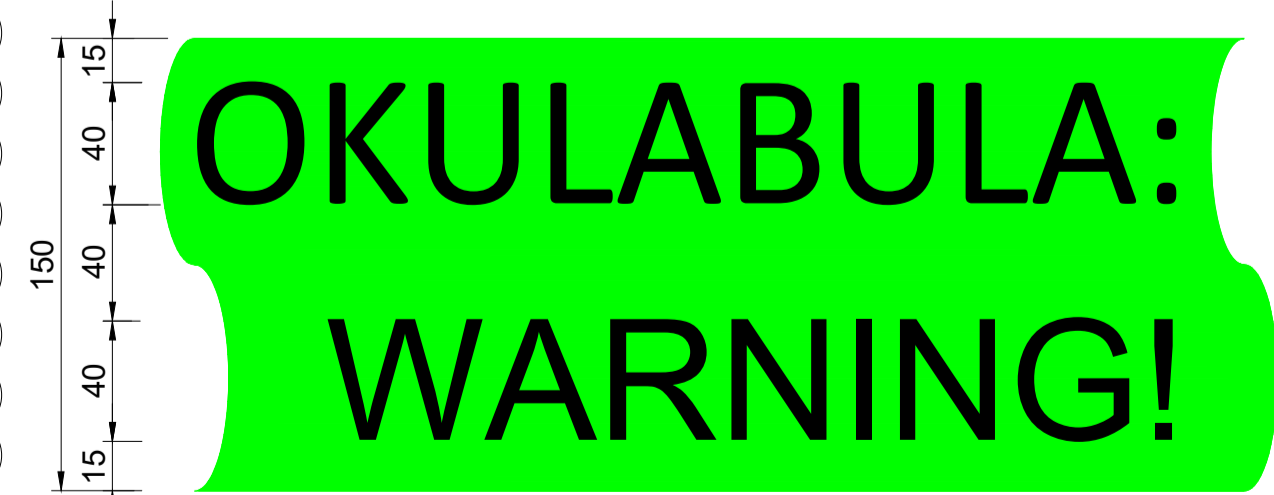

**DETAIL 3**  
**CABLE WARNING TAPE DIMENSIONS**

- GENERAL NOTES:**
- ALL DIMENSIONS ARE IN MILLIMETRES UNLESS NOTED OTHERWISE.
  - THIS DRAWING SHALL BE READ IN CONJUNCTION WITH THE PIPELINE CONSTRUCTION SPECIFICATION, DOC. NO. UT-MID-70-WPR2-190010.
  - THIS TYPICAL DETAIL APPLIES TO THE PIPELINE. MARKER TAPES FOR THE FEEDER LINE ARE SHOWN ON DRAWING NO. UG-TIF-71-WPR2-191502.
  - TAPE COLOURS SHALL BE AS FOLLOWS:  
 PIPELINE AND HV CABLE: RAL 1026 (LUMINOUS YELLOW)  
 FOC: RAL 6038 (LUMINOUS GREEN)
  - TAPES SHALL BE VIRGIN GRADE LDPE. THEY SHALL BE ROT RESISTANT IN ALL SOILS ENCOUNTERED ALONG THE ROUTE AND HAVE A SERVICE LIFE THAT EXCEEDS THE DESIGN LIFE OF THE PIPELINE. TAPES SHALL ALLOW 25% STRETCHING WITHOUT BREAKING. MINIMUM THICKNESS SHALL BE 100 MICRONS.
  - TAPES AND PIGMENTS SHALL BE FREE OF ANY SUBSTANCES THAT COULD RELEASE TOXINS INTO THE SOIL. ALL PIGMENTS SHALL BE LEAD FREE.
  - THE TAPE TYPES REQUIRED ALONG THE ROUTE ARE PROVIDED IN TABLE 1.

- HOLDS:**
- EMERGENCY CONTACT NUMBER.

**REFERENCE:**

DOCUMENT NUMBER	DOCUMENT TITLE
UT-MID-70-WPR2-190010	SPECIFICATION FOR PIPELINE CONSTRUCTION
UG-TIF-71-WPR2-191502	FEEDER LINE AND CABLE WARNING TAPES

DISTRICT	TAPE TYPE
HOIMA (PIPELINE) KIKUUBE KAKUMIRO	1
GOMBA SEMBABULE LWENGO KYANKWANZI MUBENDE KYOTERA RAKAI	2
	3

**TABLE 1 - TAPE TYPE  
 REQUIRED IN EACH DISTRICT**

Rev.	Date	Step	Revision Description	Iss.	Check.	Appr.
01	23/Nov/2022	AFC	APPROVED FOR CONSTRUCTION	NMN	JHY	MJD
00	10/Dec/2021	AFC	APPROVED FOR CONSTRUCTION	NMN	JHY	MJD

**EACOP Project** **Worley**  
 energy | chemicals | resources

This document is the property of the COMPANY and it shall not be disclosed to third parties or reproduced without the express written permission of the COMPANY.  
 This document has been generated by an Electronic Document Management System. When printed it shall be considered as "for information only". The controlled copy is the EDMS version and it is document holder's responsibility to make sure that latest version is in use.

Affiliate: Site: UTP Project Phase: DE

**TYPICAL PIPELINE DETAILS**  
**PIPELINE AND CABLE WARNING TAPES (UGANDA)**

Discipline:	PLR	Doc. Type:	TYP	Sector:	72	System:	23
Company Doc. N°:	UG-UTP-72-WPR2-191501			Class:	2	Scale:	NTS.
Contractor Doc. N°:				Format:	A1	Folio:	1 of 1